



NOTES

1. The contents of this drawing are copyright of Watts Holt.
2. It may not be copied, reproduced or altered in anyway without the written authority.
3. Do not scale. Figured dimensions only to be used.
4. Check dimensions on site before work proceeds, report any discrepancies.
5. If in doubt please ask!

Reproduced from the Measured Building Survey by Redline Surveys drawing no: Plot 1. 19- 180, dated 12th November 2019

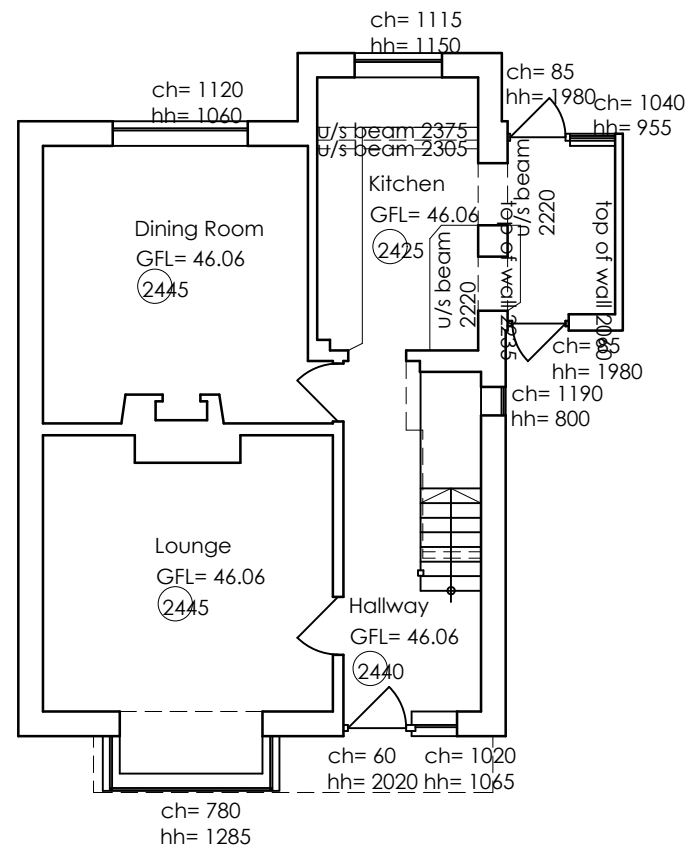

Ground Floor Plan

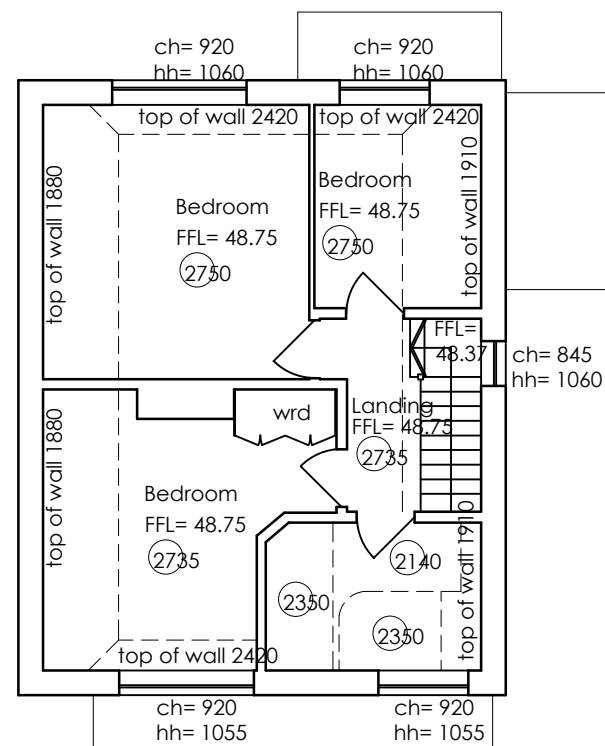

First Floor Plan

WATTS | HOLT

THE YARD
LOCH ROAD, POOLE
DORSET, BH14 9EX

W: www.wattsholt.com
T: 01202 461586
E: hello@wattsholt.com

Scale 100mm @ A3

No.	Revision.	Date	By
-----	-----------	------	----

Project

15 Vale Road, Poole

Client / Brand

Mr & Mrs J Smalley

Drawing Title

Existing Floor Plans

scale @ A3 1:100 checked .

date Nov '19 drawn JB

19189 03

Mr & Mrs J Smalley
15 Vale Road, Poole

