


# Proposed Typical Hut 63-99 - as constructed


This drawing is copyright and the property of Williams Lester Ltd. It may not be copied, reproduced or altered in any way without their written authority.  
Do not scale from this drawing, work to figured dimensions. All dimensions to be checked on site and any discrepancies reported to the Architect immediately.

## REVISION NOTES


Rev	Date	Description	Drw	Chk
A	19/03/2021	Initial Issue	EP	JG
B	29/03/2021	Planning Draft	EP	JG
C	31/03/2021	Planning Issue	EP	JG
D	29/07/2021	Title changed	AD	JG

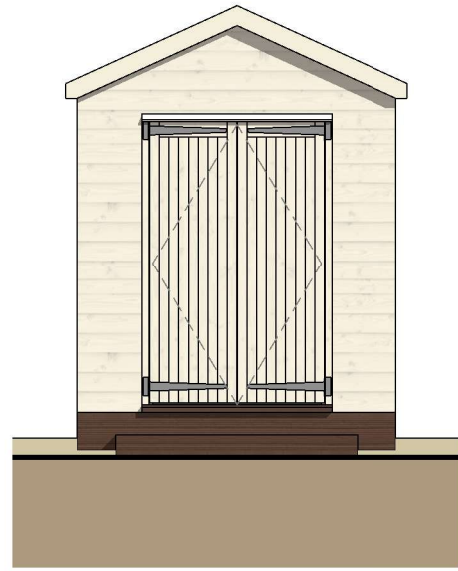


1 **Front Elevation**  
1 : 50

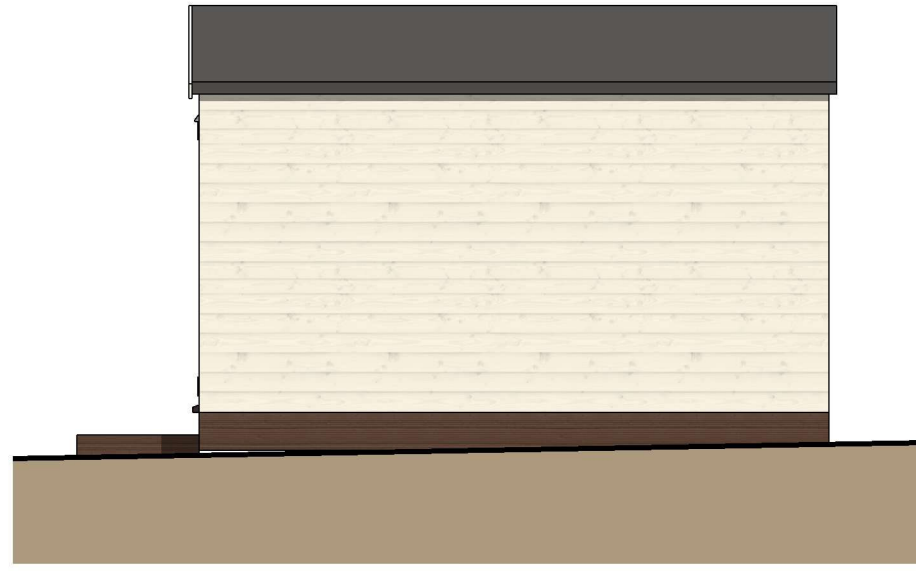


3 **Side Elevation**  
1 : 50

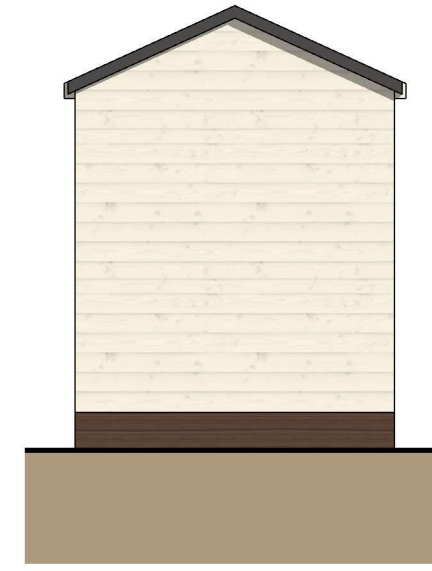

2 **Rear Elevation**  
1 : 50

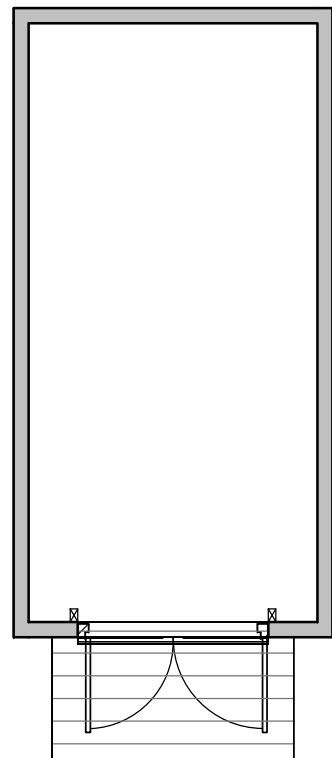


4 **Ground Floor**  
1 : 50

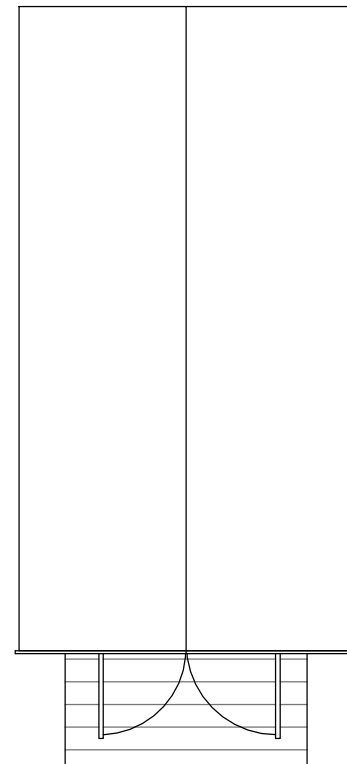

5 **Roof Plan**  
1 : 50





**WLA**WilliamsLester.

Endeavour House, Crow Arch Lane, Ringwood, BH24 1HP  
www.williamslester.com 01425 485234 mail@williamslester.com

Client  
**Avon Beach Ltd**

Project  
**Avon Beach Huts**  
Avon Beach

Title  
**Proposed Plans & Elevations - Huts 63-99**

Scale A3 @ 1 : 50

Revision  
**D**  
Suitability Suitability Description

Drawing No.  
**6058-WLA-ZZ-XX-DR-A-0103**

Plot date: 29/07/2021 15:15:10 P:\6058-Avon Beach Huts\1. Drawings\1.1 WIP (Work in Progress)\1.1. Rev\6058-WLA-ZZ-XX-DR-A-Avon Beach Huts\_Deschedrvt