

Location Plan  
Scale 1:1250 @A1 / 1:2500 @ A3



Application Site - View 1



Application Site - View 2



Block Plan  
Scale 1:500 @A1 / 1:1000 @ A3



rev:  
A\_2025.07.24\_Red line revised, substation added, Block A bin store  
moved\_ES  
B\_2025.08.21\_NMA Application\_NA

Drawn By : ES Checked By : DJ

## Southbourne Cross Car Park, Southbourne


Location & Block Plans

1820 70B

davidjames architects & partners ltd

tel: 01202 755633

Note: Do not scale from this drawing. This drawing is copyright and remains the property of David James Architects & Partners Ltd. Unauthorised use for any purpose is prohibited. ©

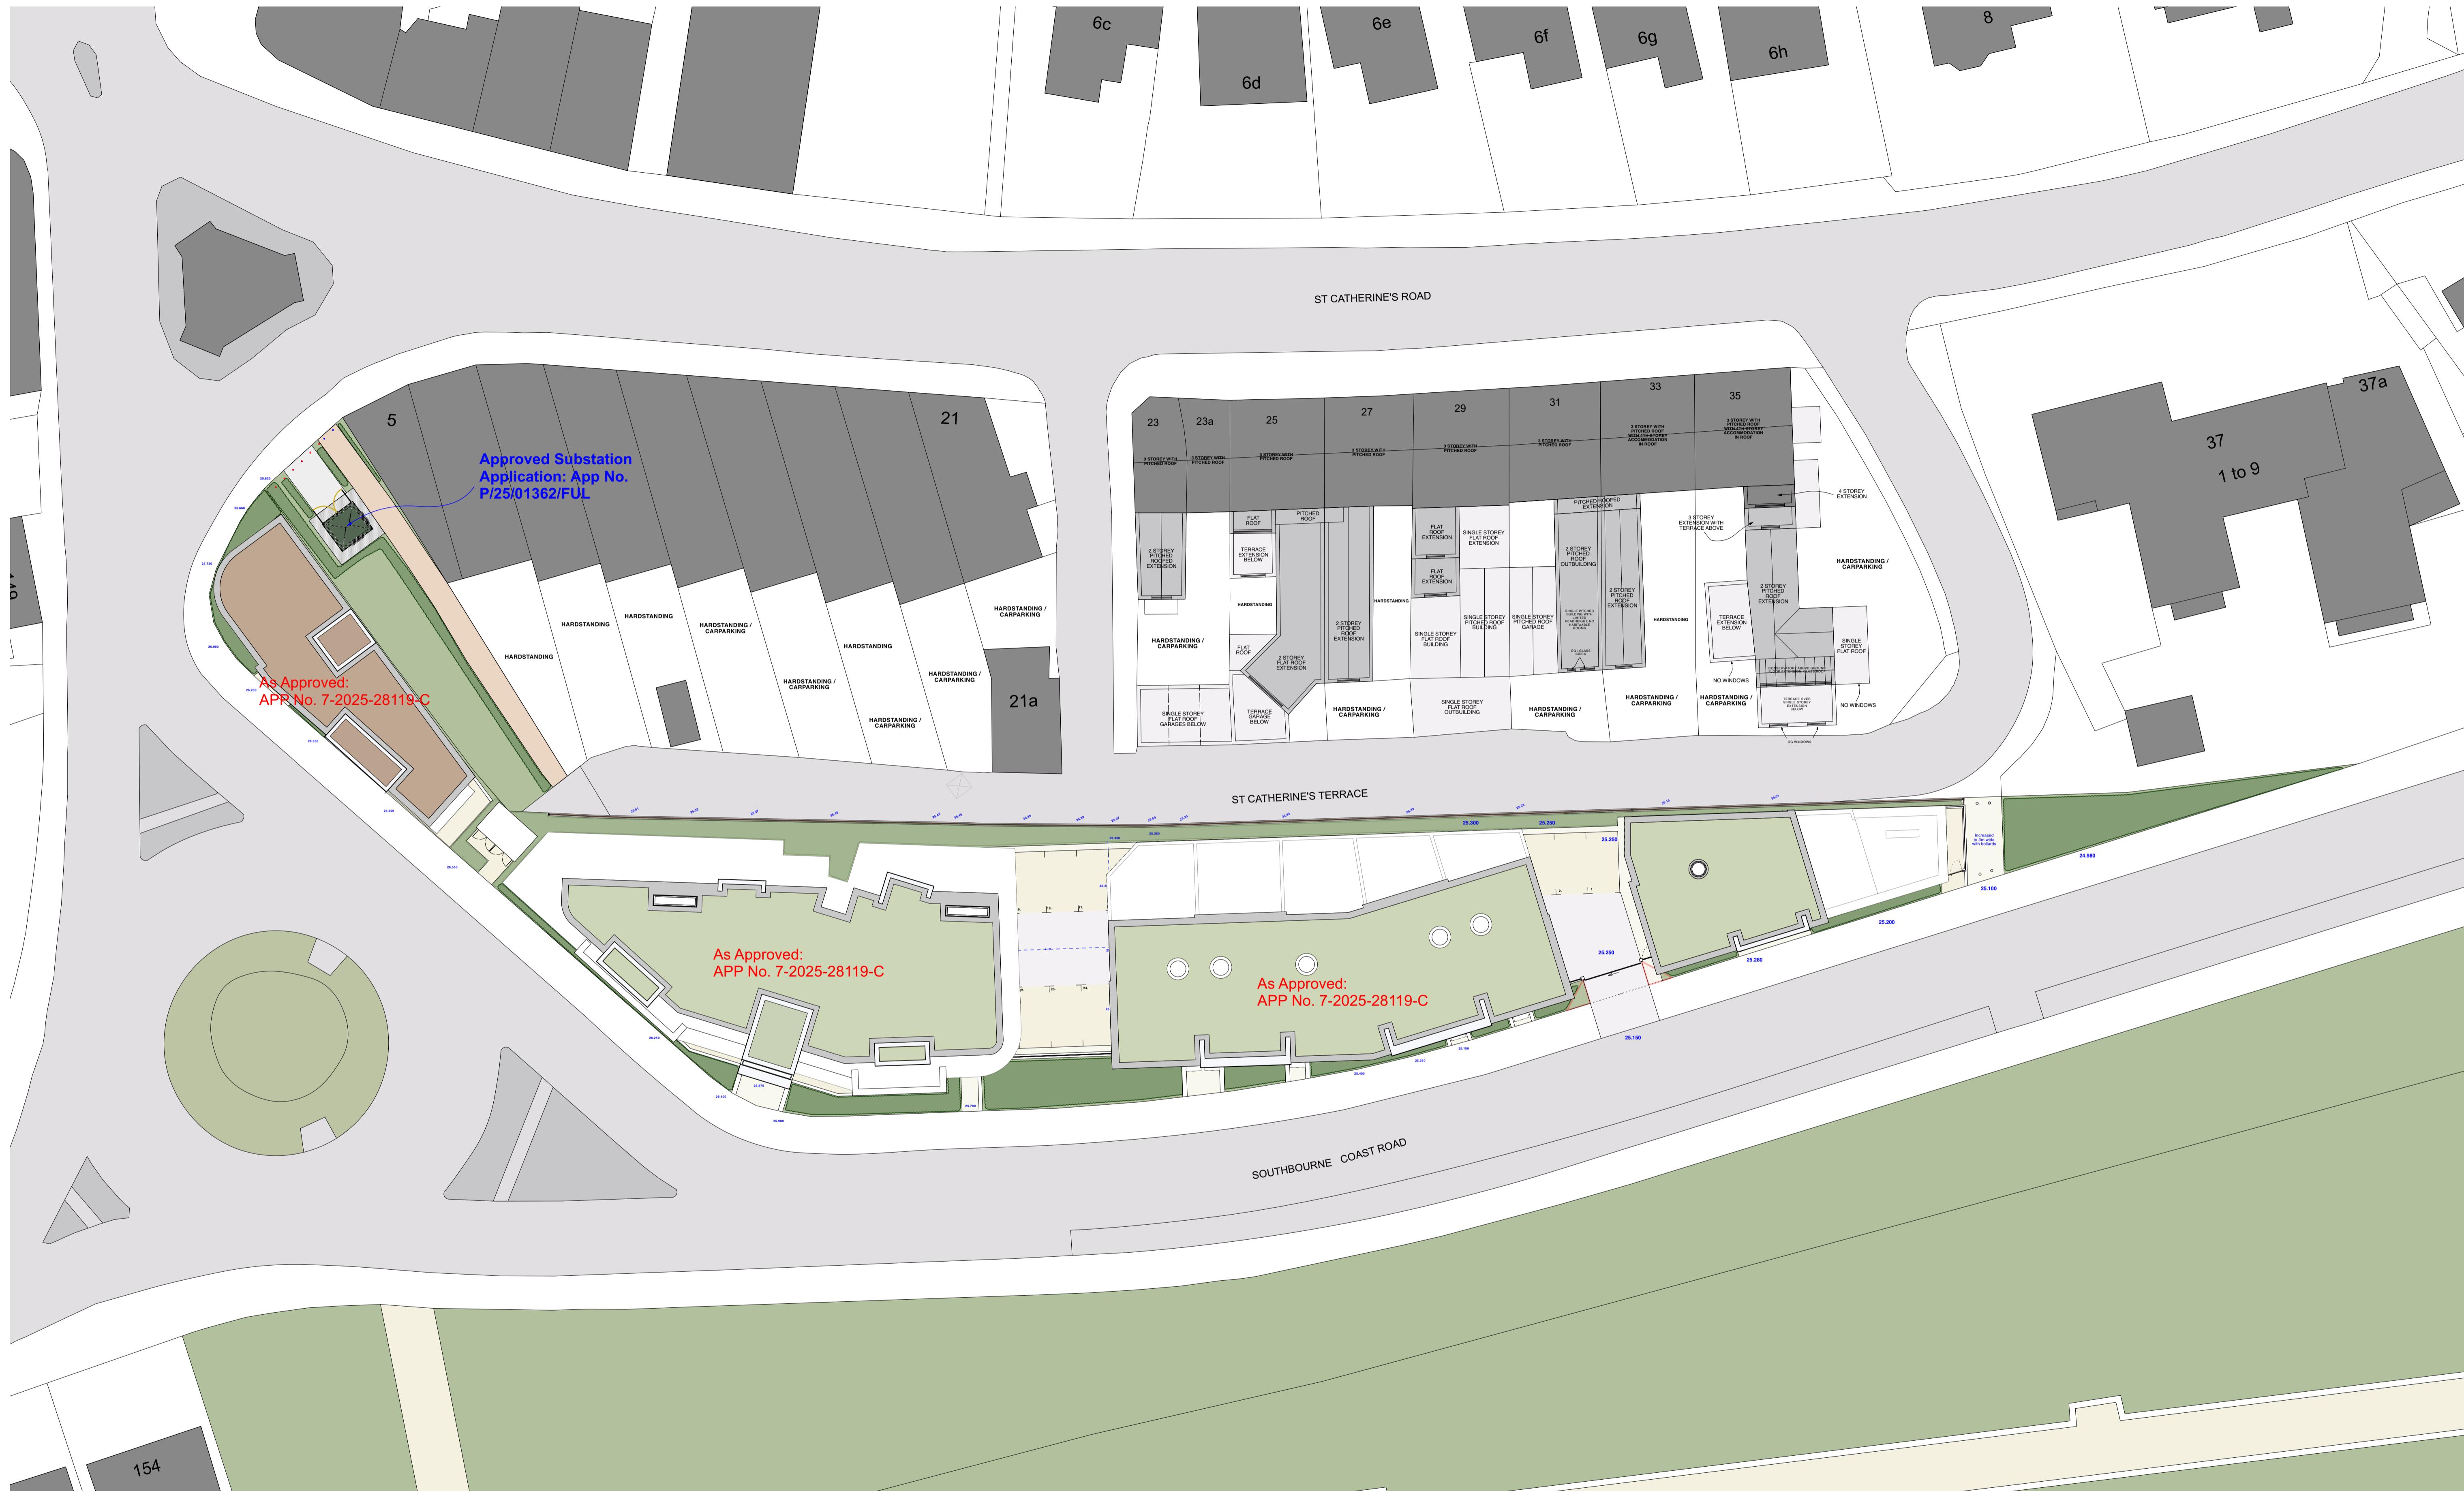

Site Plan - showing roof plan

Scale 1:250 @A1 / 1:500 @ A3

10m

1 2 3 4 5

10m

rev: A 2025.02.05 Brown roof added to Block A\_ES  
 B 2025.03.14 Block A lift overrun position corrected\_ES  
 C 2025.07.24 Substation added, Block A bin store details\_ES  
 D\_2025.08.21\_NMA Application\_NA

dja.

Southbourne Cross Car Park, Southbourne

Site Plan - showing roof plan

1820 72D

davidjames architects & partners ltd

tel: 01202 755633


Drawn By : ES Checked By : DJ

Note: Do not scale from this drawing. This drawing is copyright and remains the property of David James Architects & Partners Ltd. Unauthorised use for any purpose is prohibited. ©




Ground Floor Plan

Scale 1:100 @A1 / 1:200 @ A3

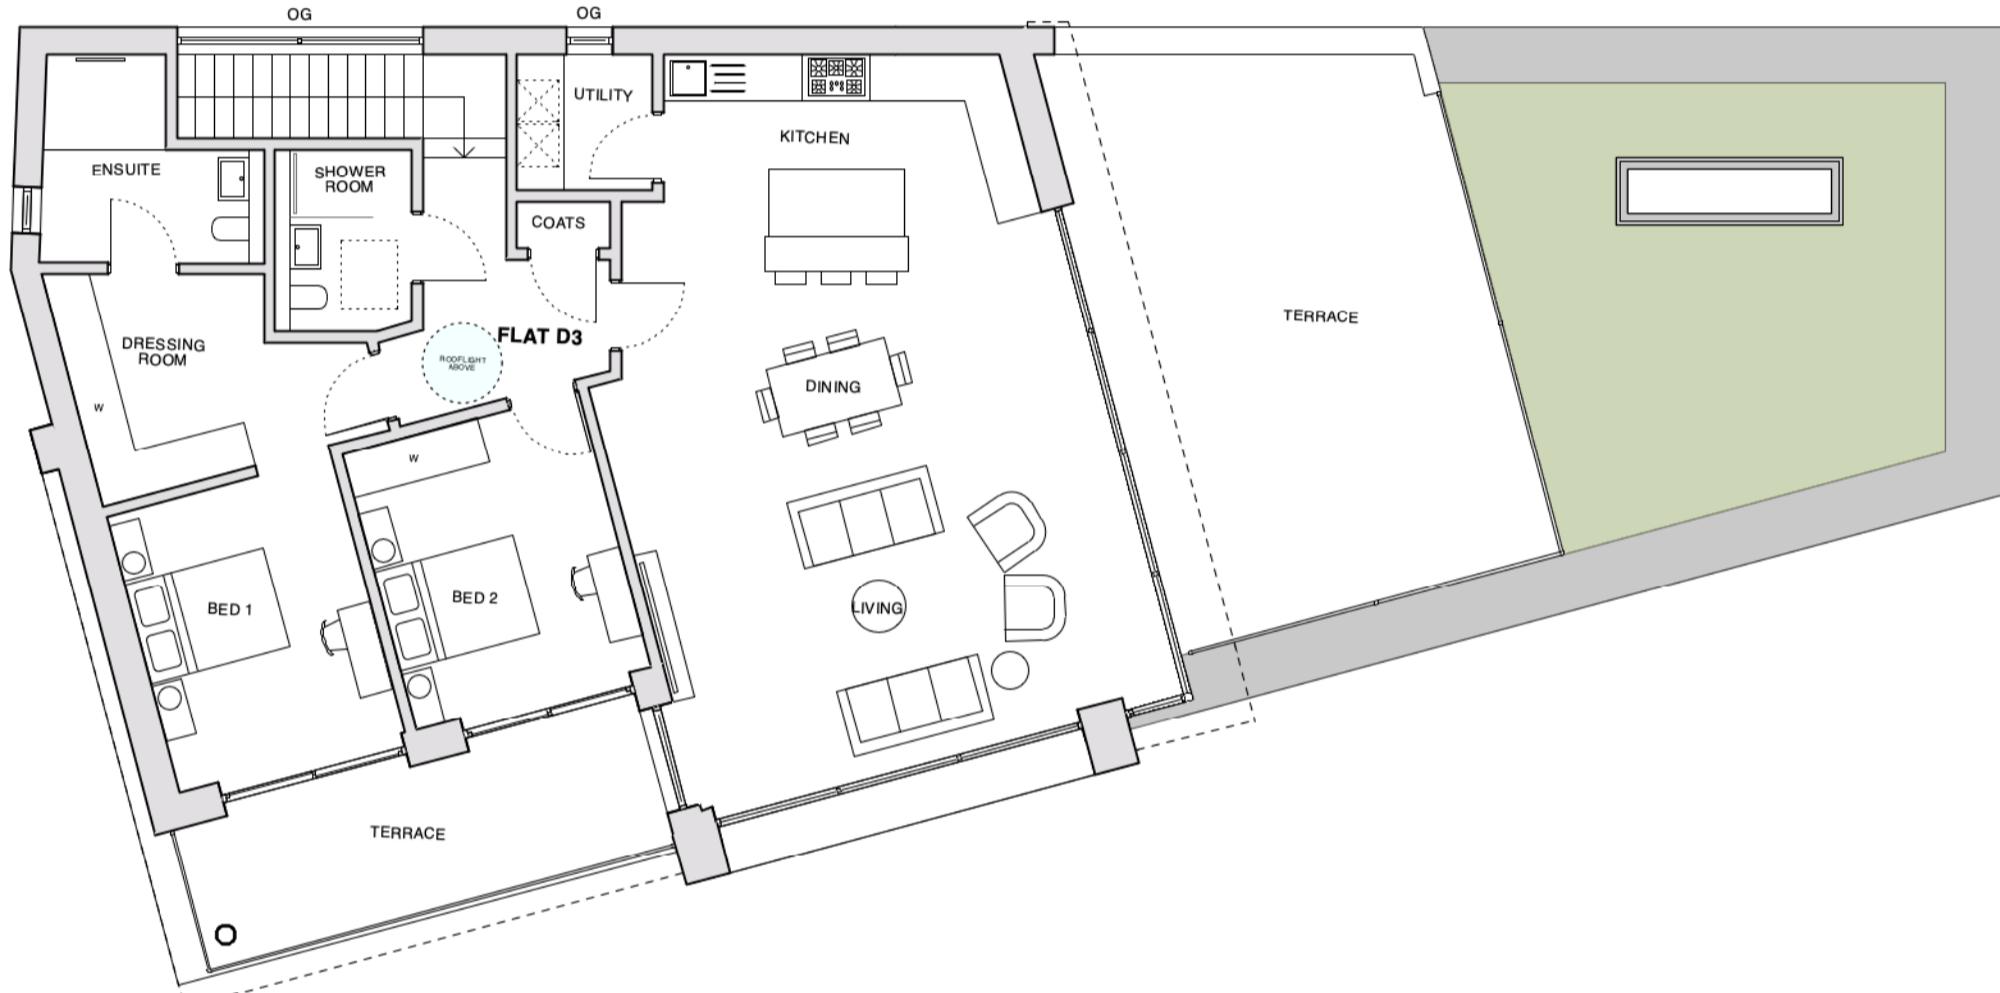

First Floor Plan


Scale 1:100 @A1 / 1:200 @ A3

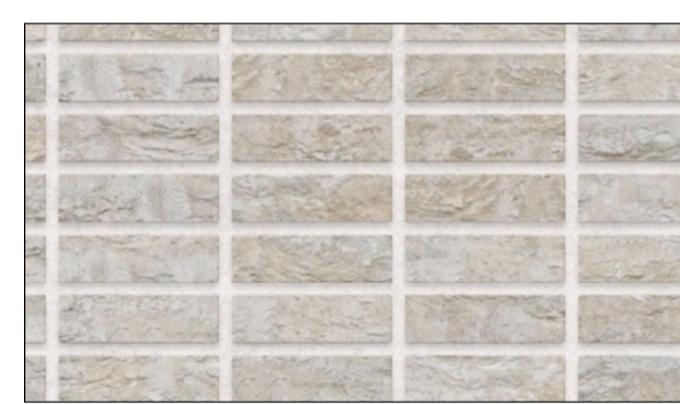

Stack bond brickwork



Stretcher bond brickwork

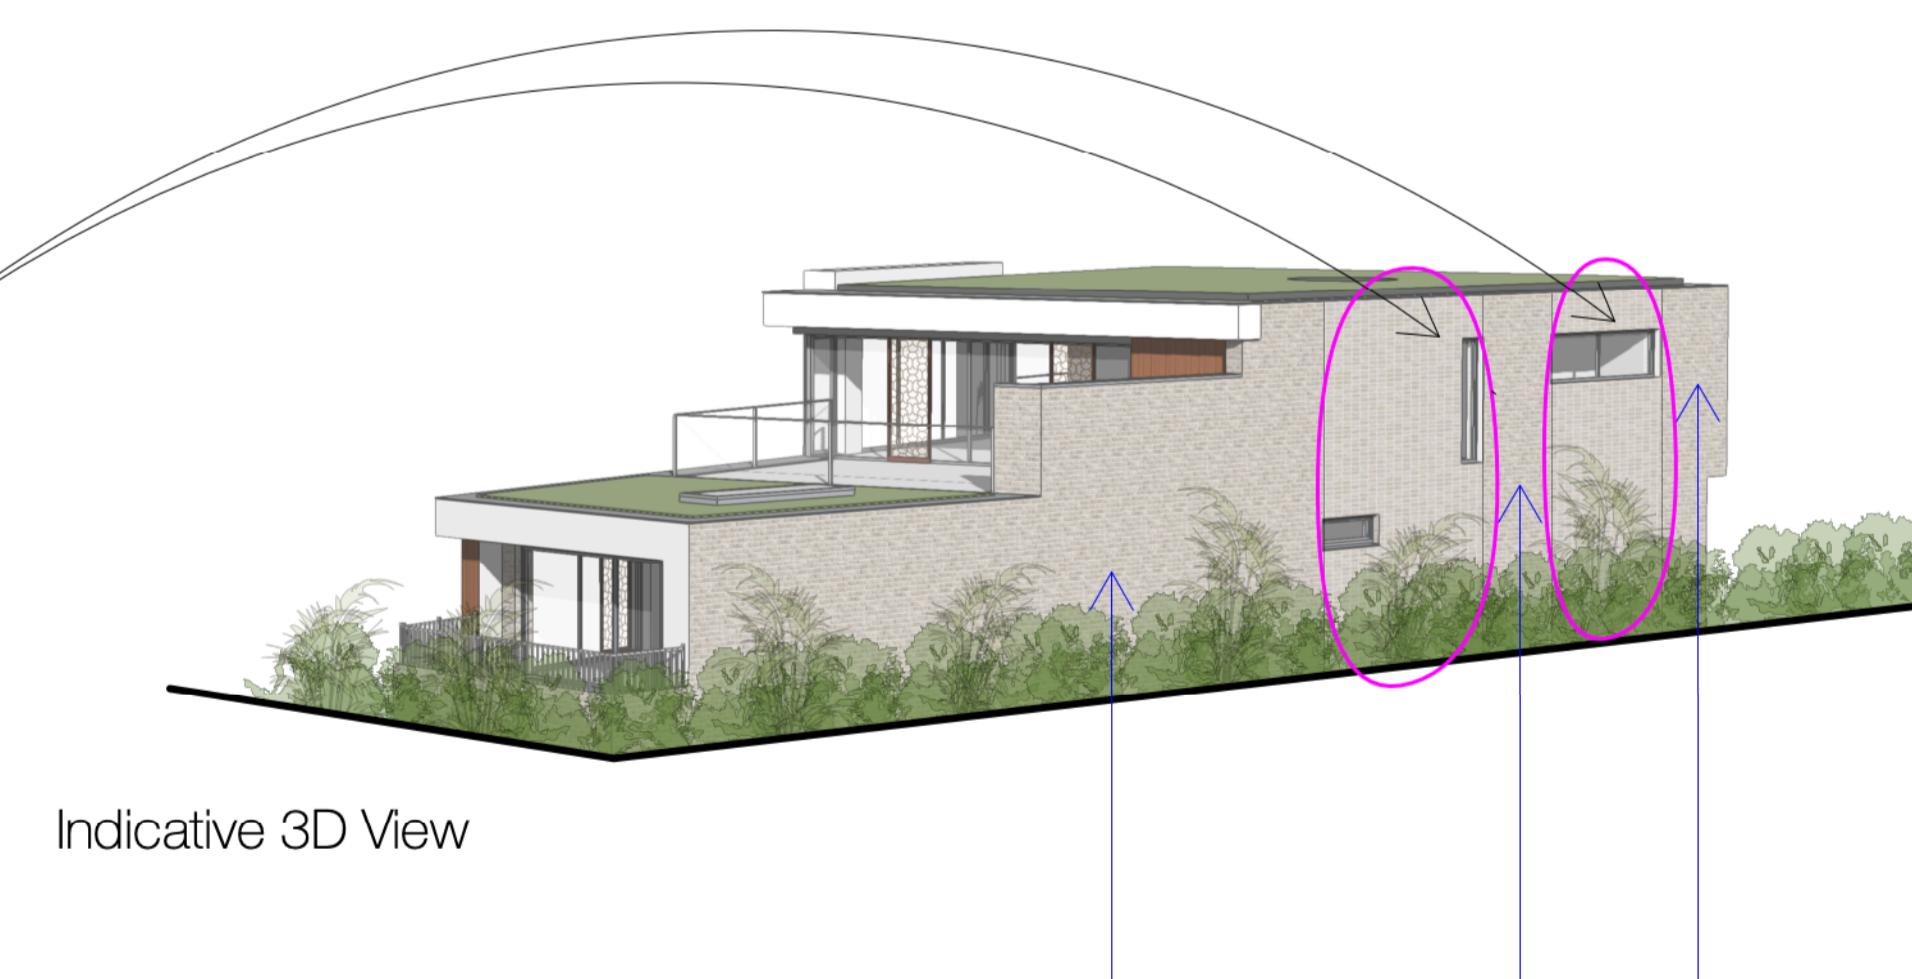

Indicative 3D View

## BLOCK D

1 2 3 4 5 10m



Front Elevation (South)

Scale 1:100 @A1 / 1:200 @ A3



Back Elevation (North)

Scale 1:100 @A1 / 1:200 @ A3




Side Elevation (West)

Scale 1:100 @A1 / 1:200 @ A3



Indicative 3D View

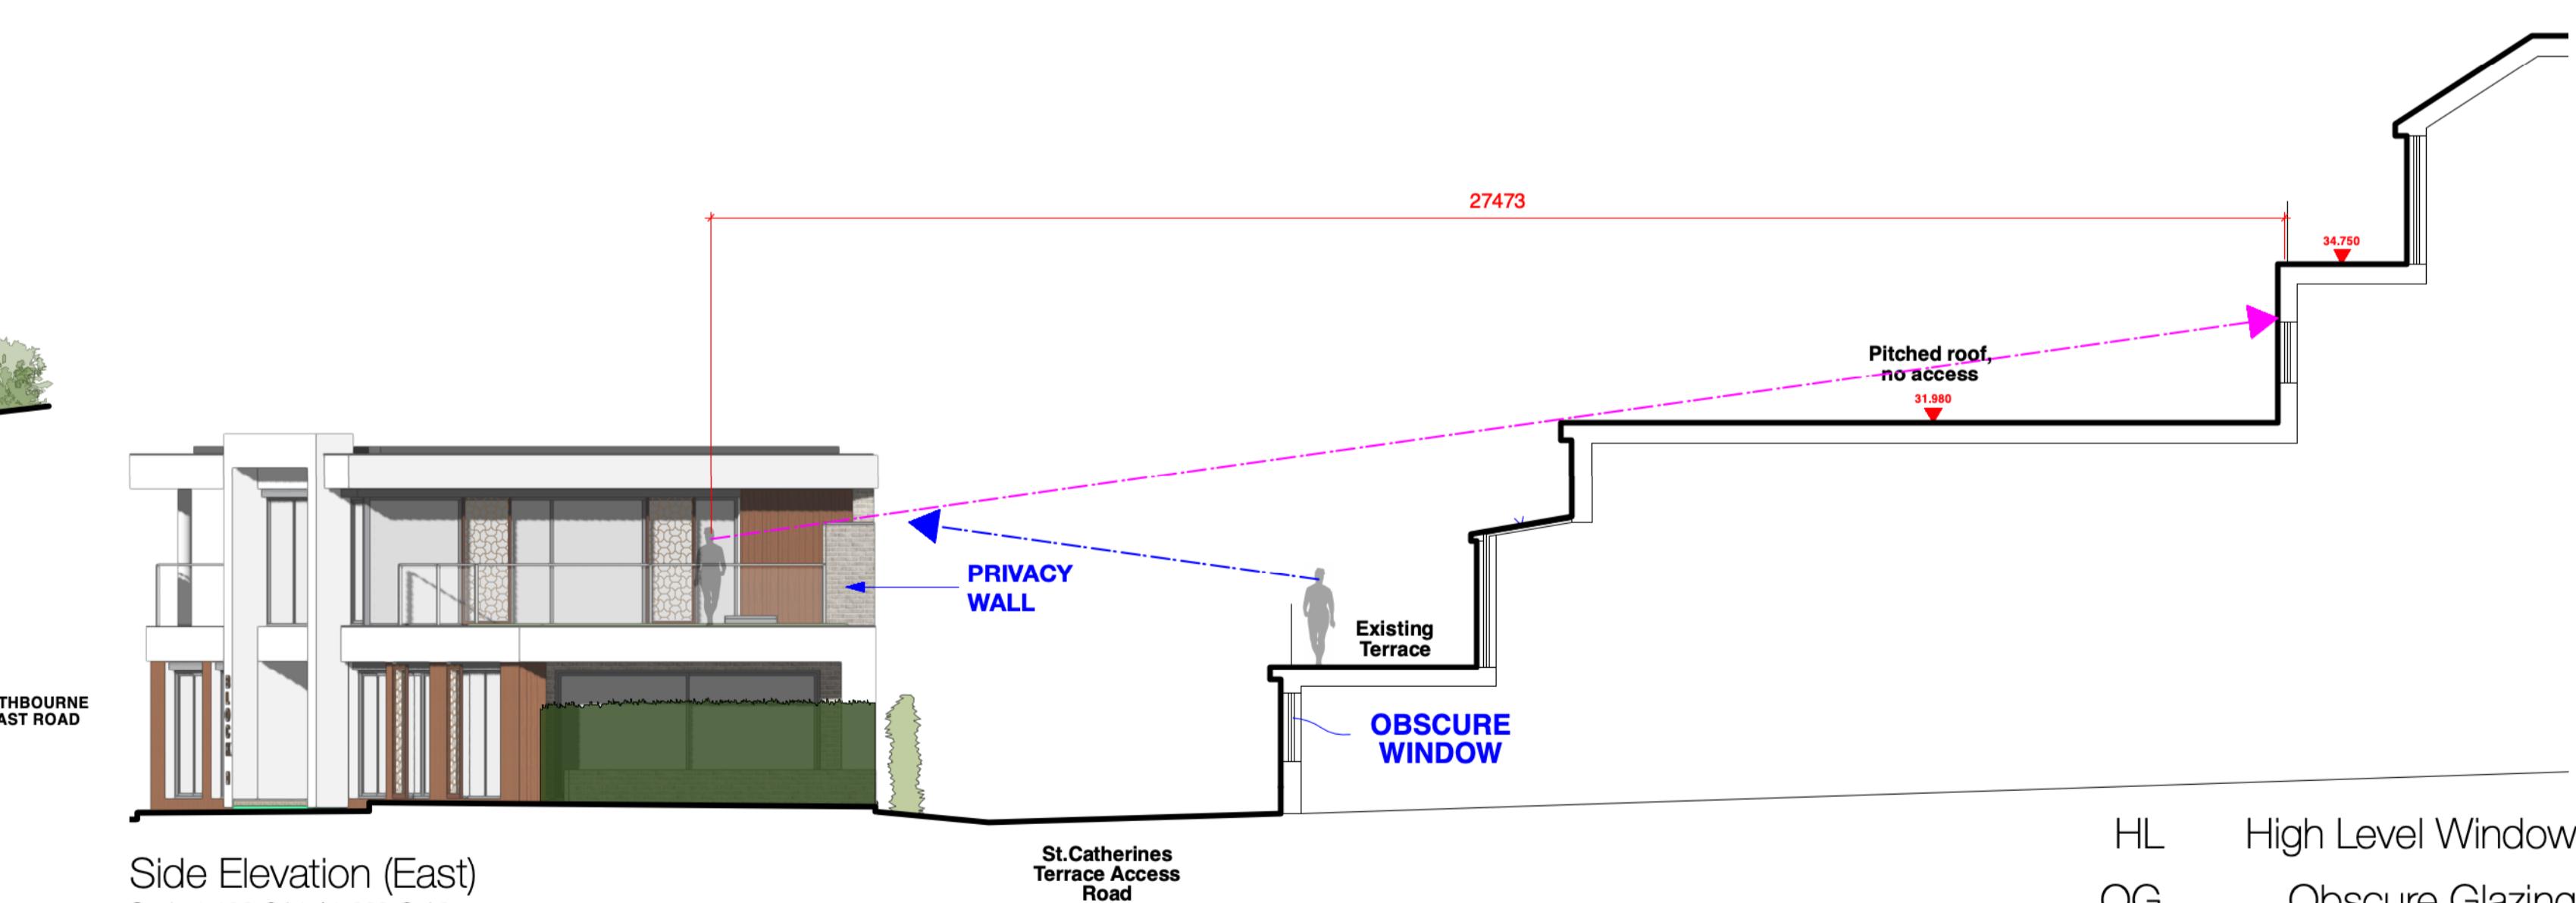

Side Elevation (East)

Scale 1:100 @A1 / 1:200 @ A3

HL High Level Window

OG Obscure Glazing

\* Obscure Glazing

rev: A\_2025.02.14\_Brick pattern added to rear elevations hedge.  
raised\_ES  
B\_2025.03.31\_Brick pattern detail added\_ES  
C\_2025.07.24\_Screen wall added\_ES

Southbourne Cross Car Park, Southbourne

dja.

Drawn By : KVP Checked By : DJ

Block D - Plans & Elevations

1820 84C

davidjames architects & partners ltd

tel: 01202 755633

Note: Do not scale from this drawing. This drawing is copyright and remains the property of David James Architects & Partners Ltd. Unauthorised use for any purpose is prohibited. ©