


LANCASTER DRIVE

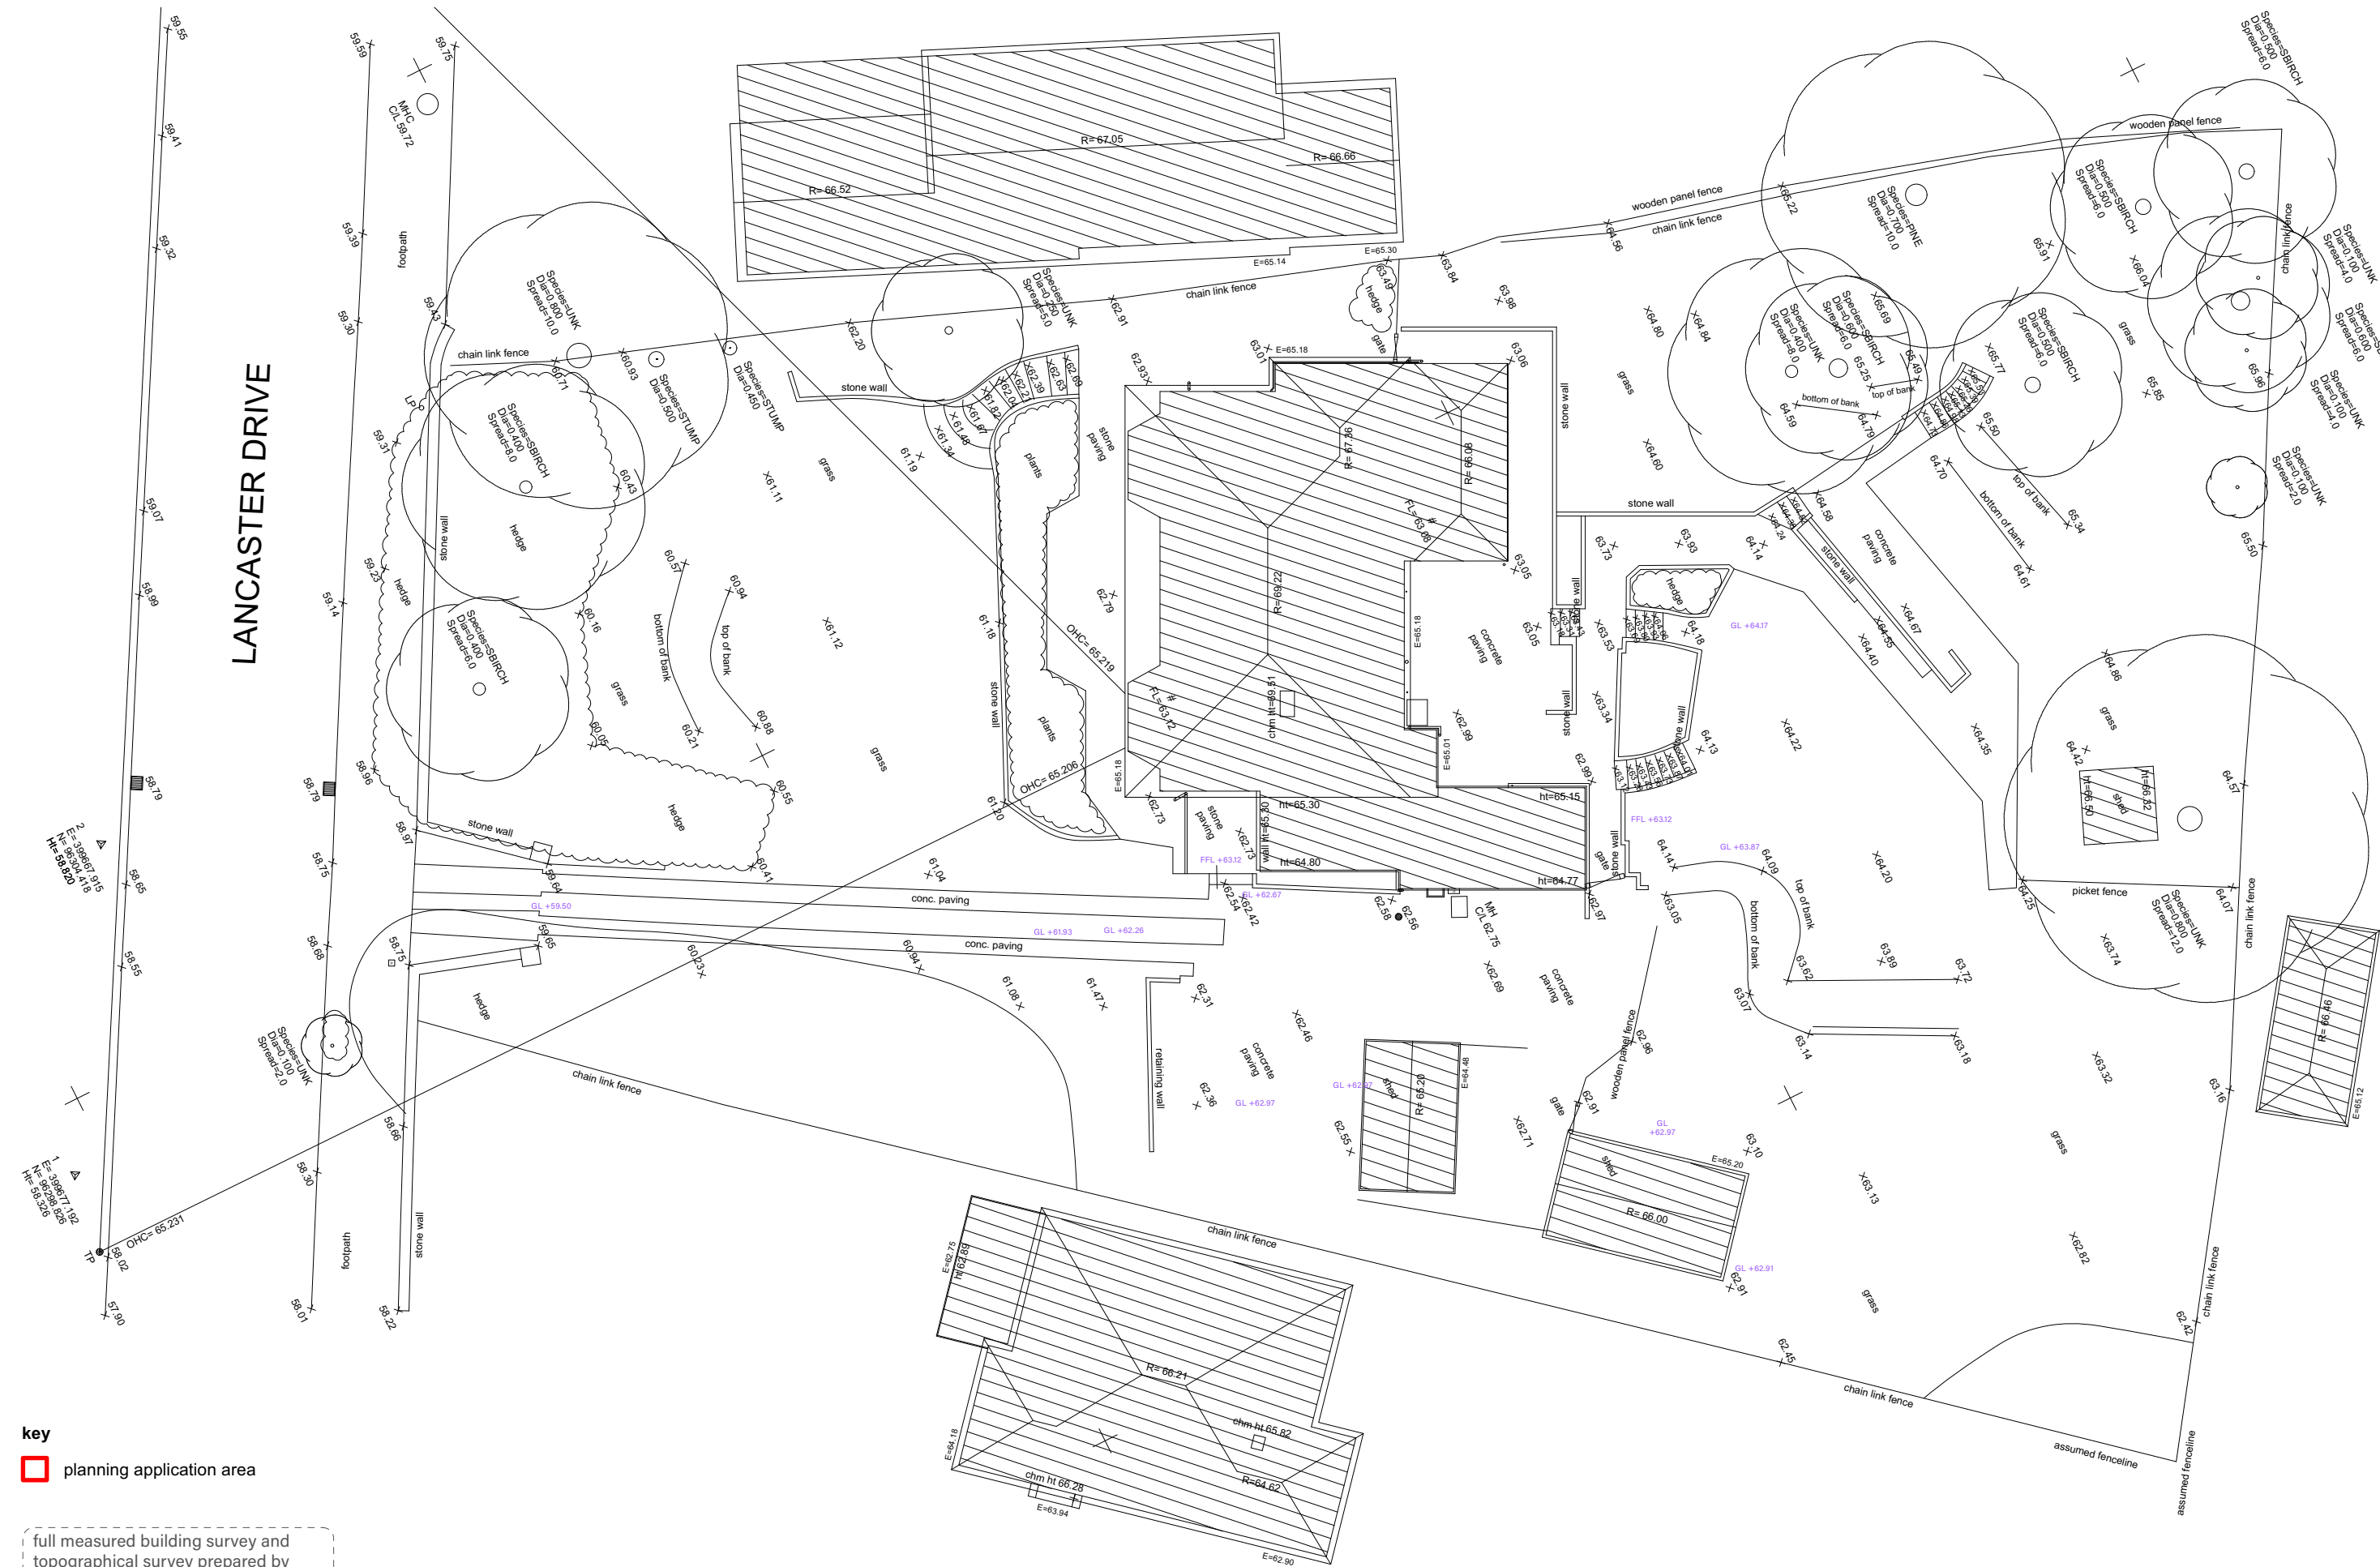

key
□ planning application area

full measured building survey and
topographical survey prepared by
Redline Surveys (dated 22.01.2026)