




existing south east elevation (side) 1_100@a3

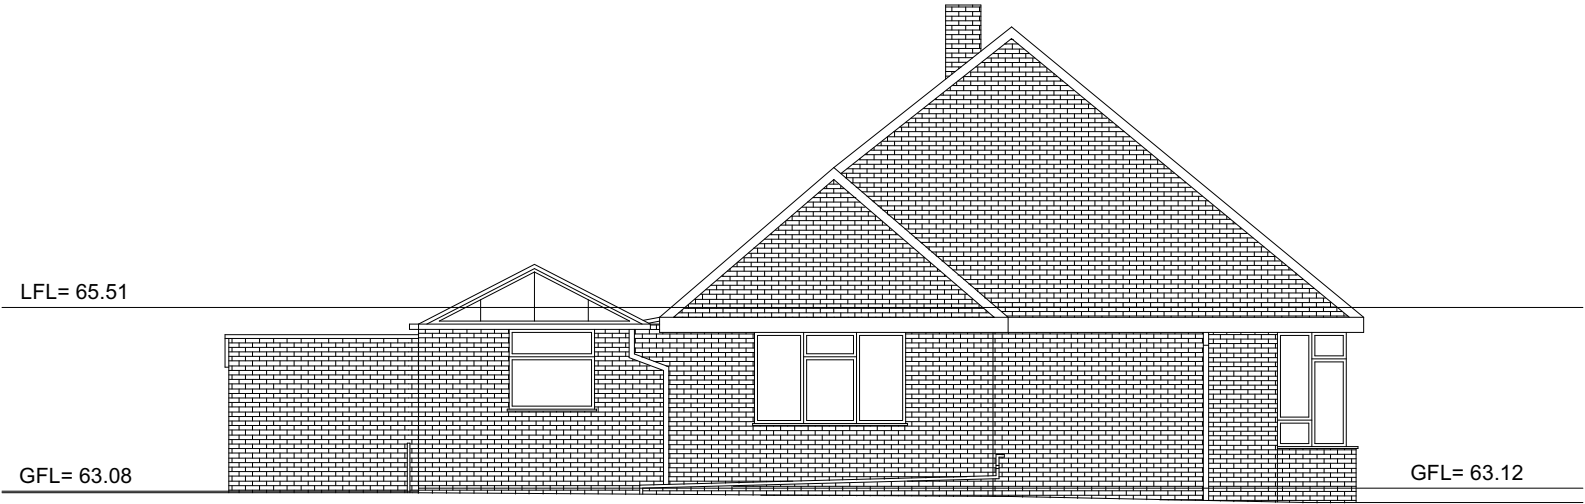

existing north west elevation (side) 1_100@a3

full measured building survey and
topographical survey prepared by
Redline Surveys (dated 22.01.2026)