




existing south west elevation (front) 1_100@a3

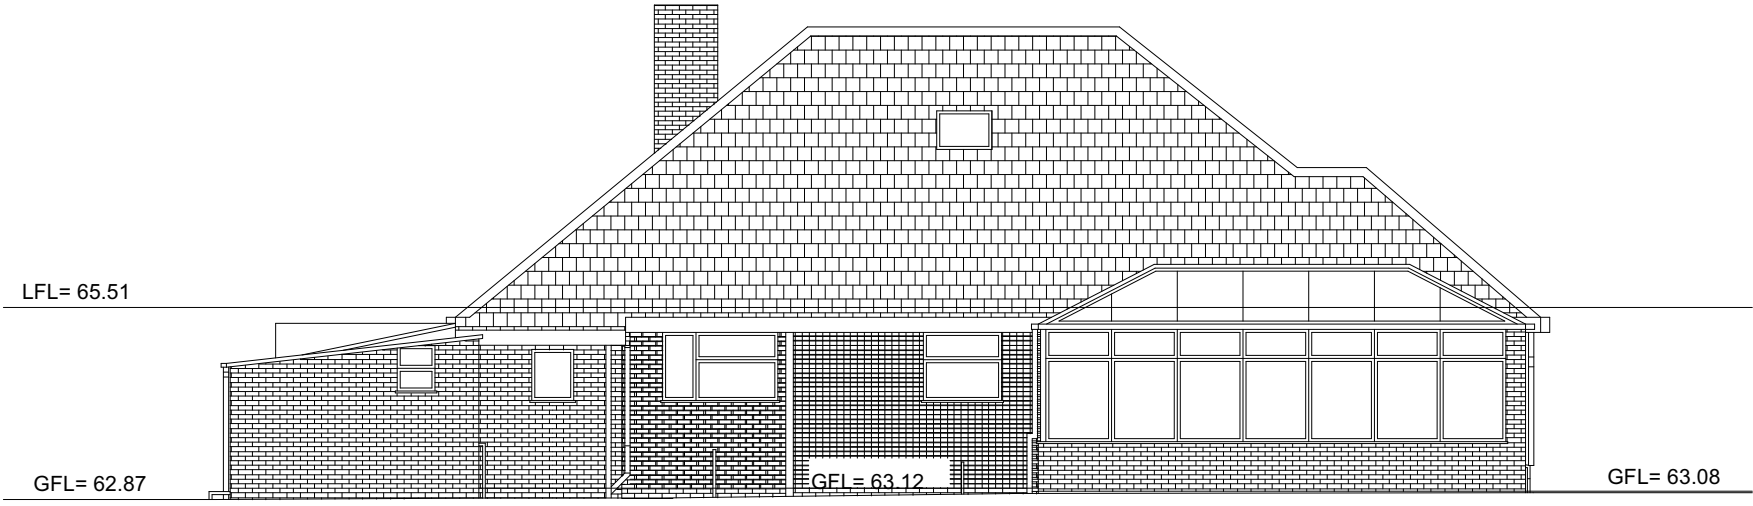

existing north east elevation (rear) 1_100@a3

full measured building survey and
topographical survey prepared by
Redline Surveys (dated 22.01.2026)