


Appendix 13 Map of Poole Park and key locations

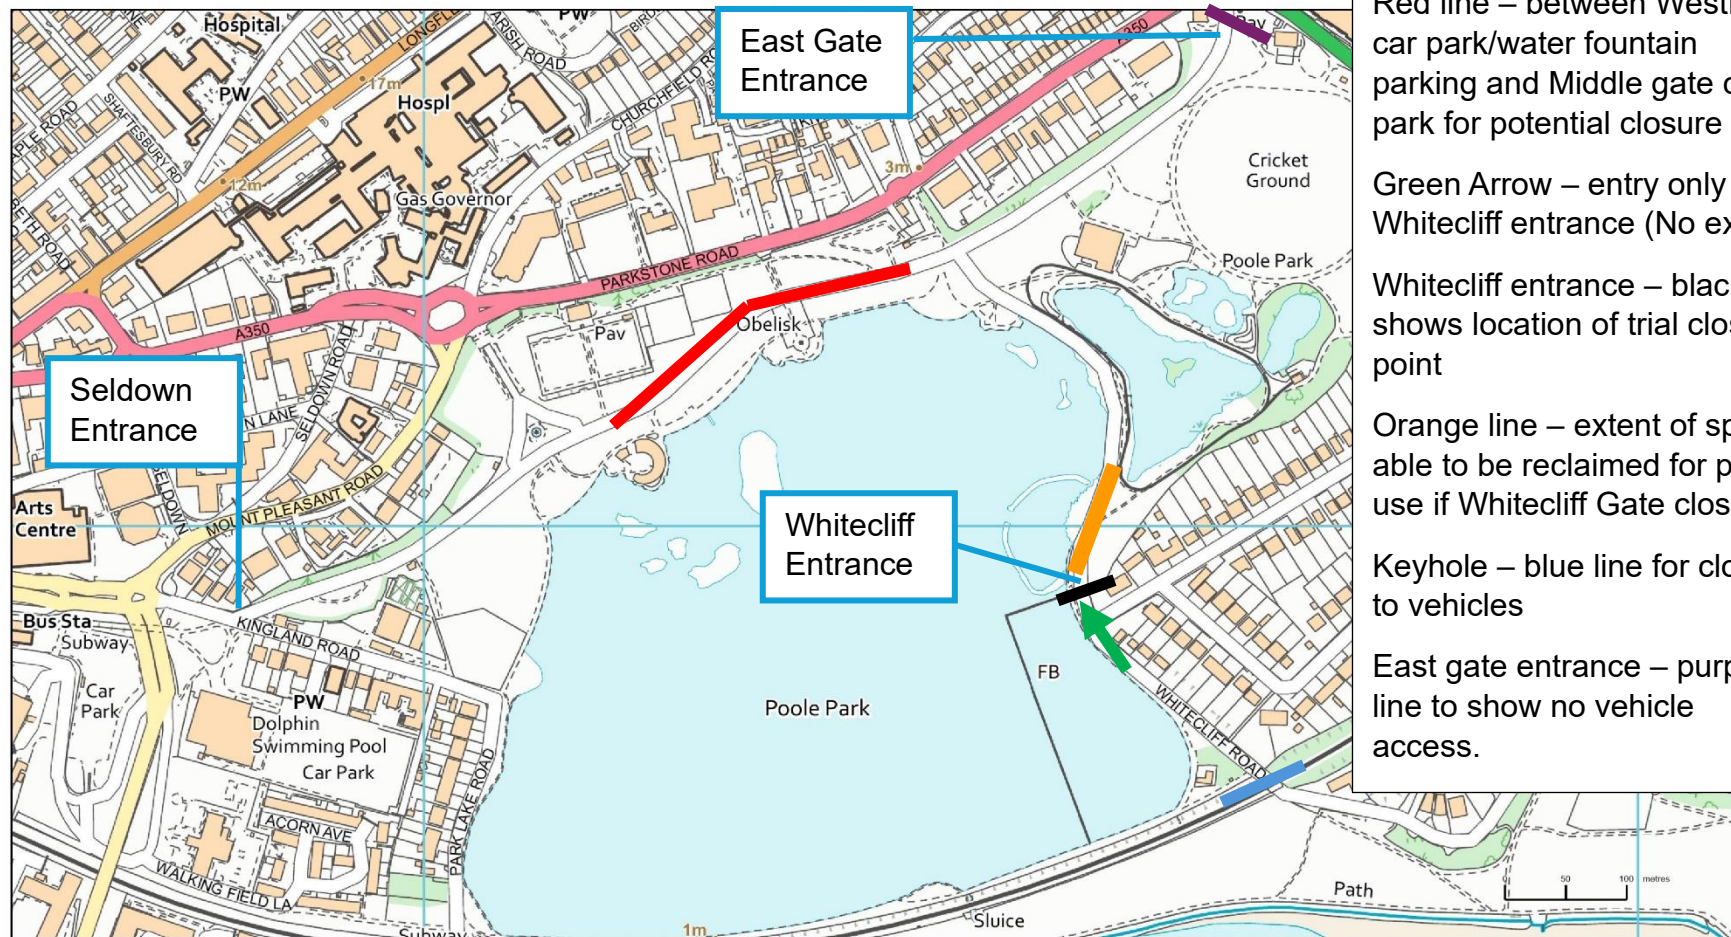

Red line – between Westfield car park/water fountain parking and Middle gate car park for potential closure

Green Arrow – entry only via Whitecliff entrance (No exit)

Whitecliff entrance – black line shows location of trial closure point

Orange line – extent of space able to be reclaimed for park use if Whitecliff Gate closed

Keyhole – blue line for closure to vehicles

East gate entrance – purple line to show no vehicle access.

Poole Park

☐ BCP_Boundary



Scale: 1:5000 @ A4

Date: 28 March 2024

Creator: USER NAME

© Crown copyright and database rights 2024 - OS AC0000808082

You are permitted to use this data solely to enable you to respond to, or interact with, the organisation that provided you with the data. You are not permitted to copy, sub-licence, distribute or sell any of this data to third parties in any form.

